

CPZ LEGEND


- RESIDENT BAY
RESIDENT/BUSINESS BAY
RESIDENT/SHORT STAY BAY
1 HOUR FREE/SHORT STAY
BUSINESS BAY
DISABLED BAY
LOADING BAY
NEW POST
NEW LARGE POST
LAMP COLUMN
ZONE BOUNDARY
SINGLE YELLOW LINE
DOUBLE YELLOW LINE
ROAD NOT INCLUDED IN CPZ
RESIDENTS/BUSINESS
ARE ELIGIBLE FOR PERMITS
- RESBUS
DISABLED
LOADING

CPZ NOTES:

- MORTLAKE CPZ OPERATES MON - FRI 9:00am - 11:00pm
- ALL FOOTWAY PARKING EXEMPTIONS 0.3M UNLESS STATED OTHERWISE
- ALL SINGLE YELLOW LINES OPERATE MON - FRI 9:00am - 11:00pm UNLESS STATED OTHERWISE
- NEW POSTS ARE SUBJECT TO RELOCATION DURING IMPLEMENTATION


GENERAL NOTES:

- DO NOT SCALE FROM DRAWINGS.
- ALL DIMENSIONS ARE IN METRES UNLESS NOTED OTHERWISE.
- ALL SETOUT TO FACE OF KERB.
- ALL DIMENSIONS TO BE VERIFIED ON SITE BY THE CONTRACTOR WITH THE SUPERVISING ENGINEER.
- THESE PLANS ARE TO BE READ IN CONJUNCTION WITH THE HIGHWAY WORKS STANDARD DRAWINGS FOR THE TERM CONTRACT 2004-2007.
- ALL HIGHWAY WORKS ARE TO BE UNDERTAKEN IN ACCORDANCE WITH THE CURRENT TERM CONTRACT FOR MAJOR CIVIL ENGINEERING WORKS 2004-2007.
- TEMPORARY TRAFFIC MANAGEMENT MEASURES DURING CONSTRUCTION SHALL BE AS PER SAFETY AT STREET WORKS AND ROAD WORKS - A CODE OF PRACTICE: MANUAL.
- FOR ALL SIGN CODES REFER TO THE TRAFFIC SIGNS REGULATIONS AND GENERAL DIRECTIONS 2002.
- ALL UNMARKING TO CHAPTER 5 OF THE TRAFFIC SIGNS MANUAL 2003 AND THE TRAFFIC SIGNS REGULATIONS AND GENERAL DIRECTIONS 2002.
- ELECTRICAL WORKS ARE TO BE UNDERTAKEN WITH THE APPROPRIATE CURRENT TERM CONTRACT.

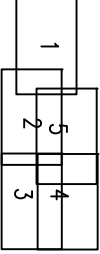

Local LONDON BOROUGH OF RICHMOND UPON THAMES

Project	MORTLAKE CPZ
Drawing Title	MORTLAKE CPZ SHEET 1 OF 5
Drawing Office	RICHMOND
Telephone	020-8487 5296
Drawing Number	1032_DD_101_001
Version	D

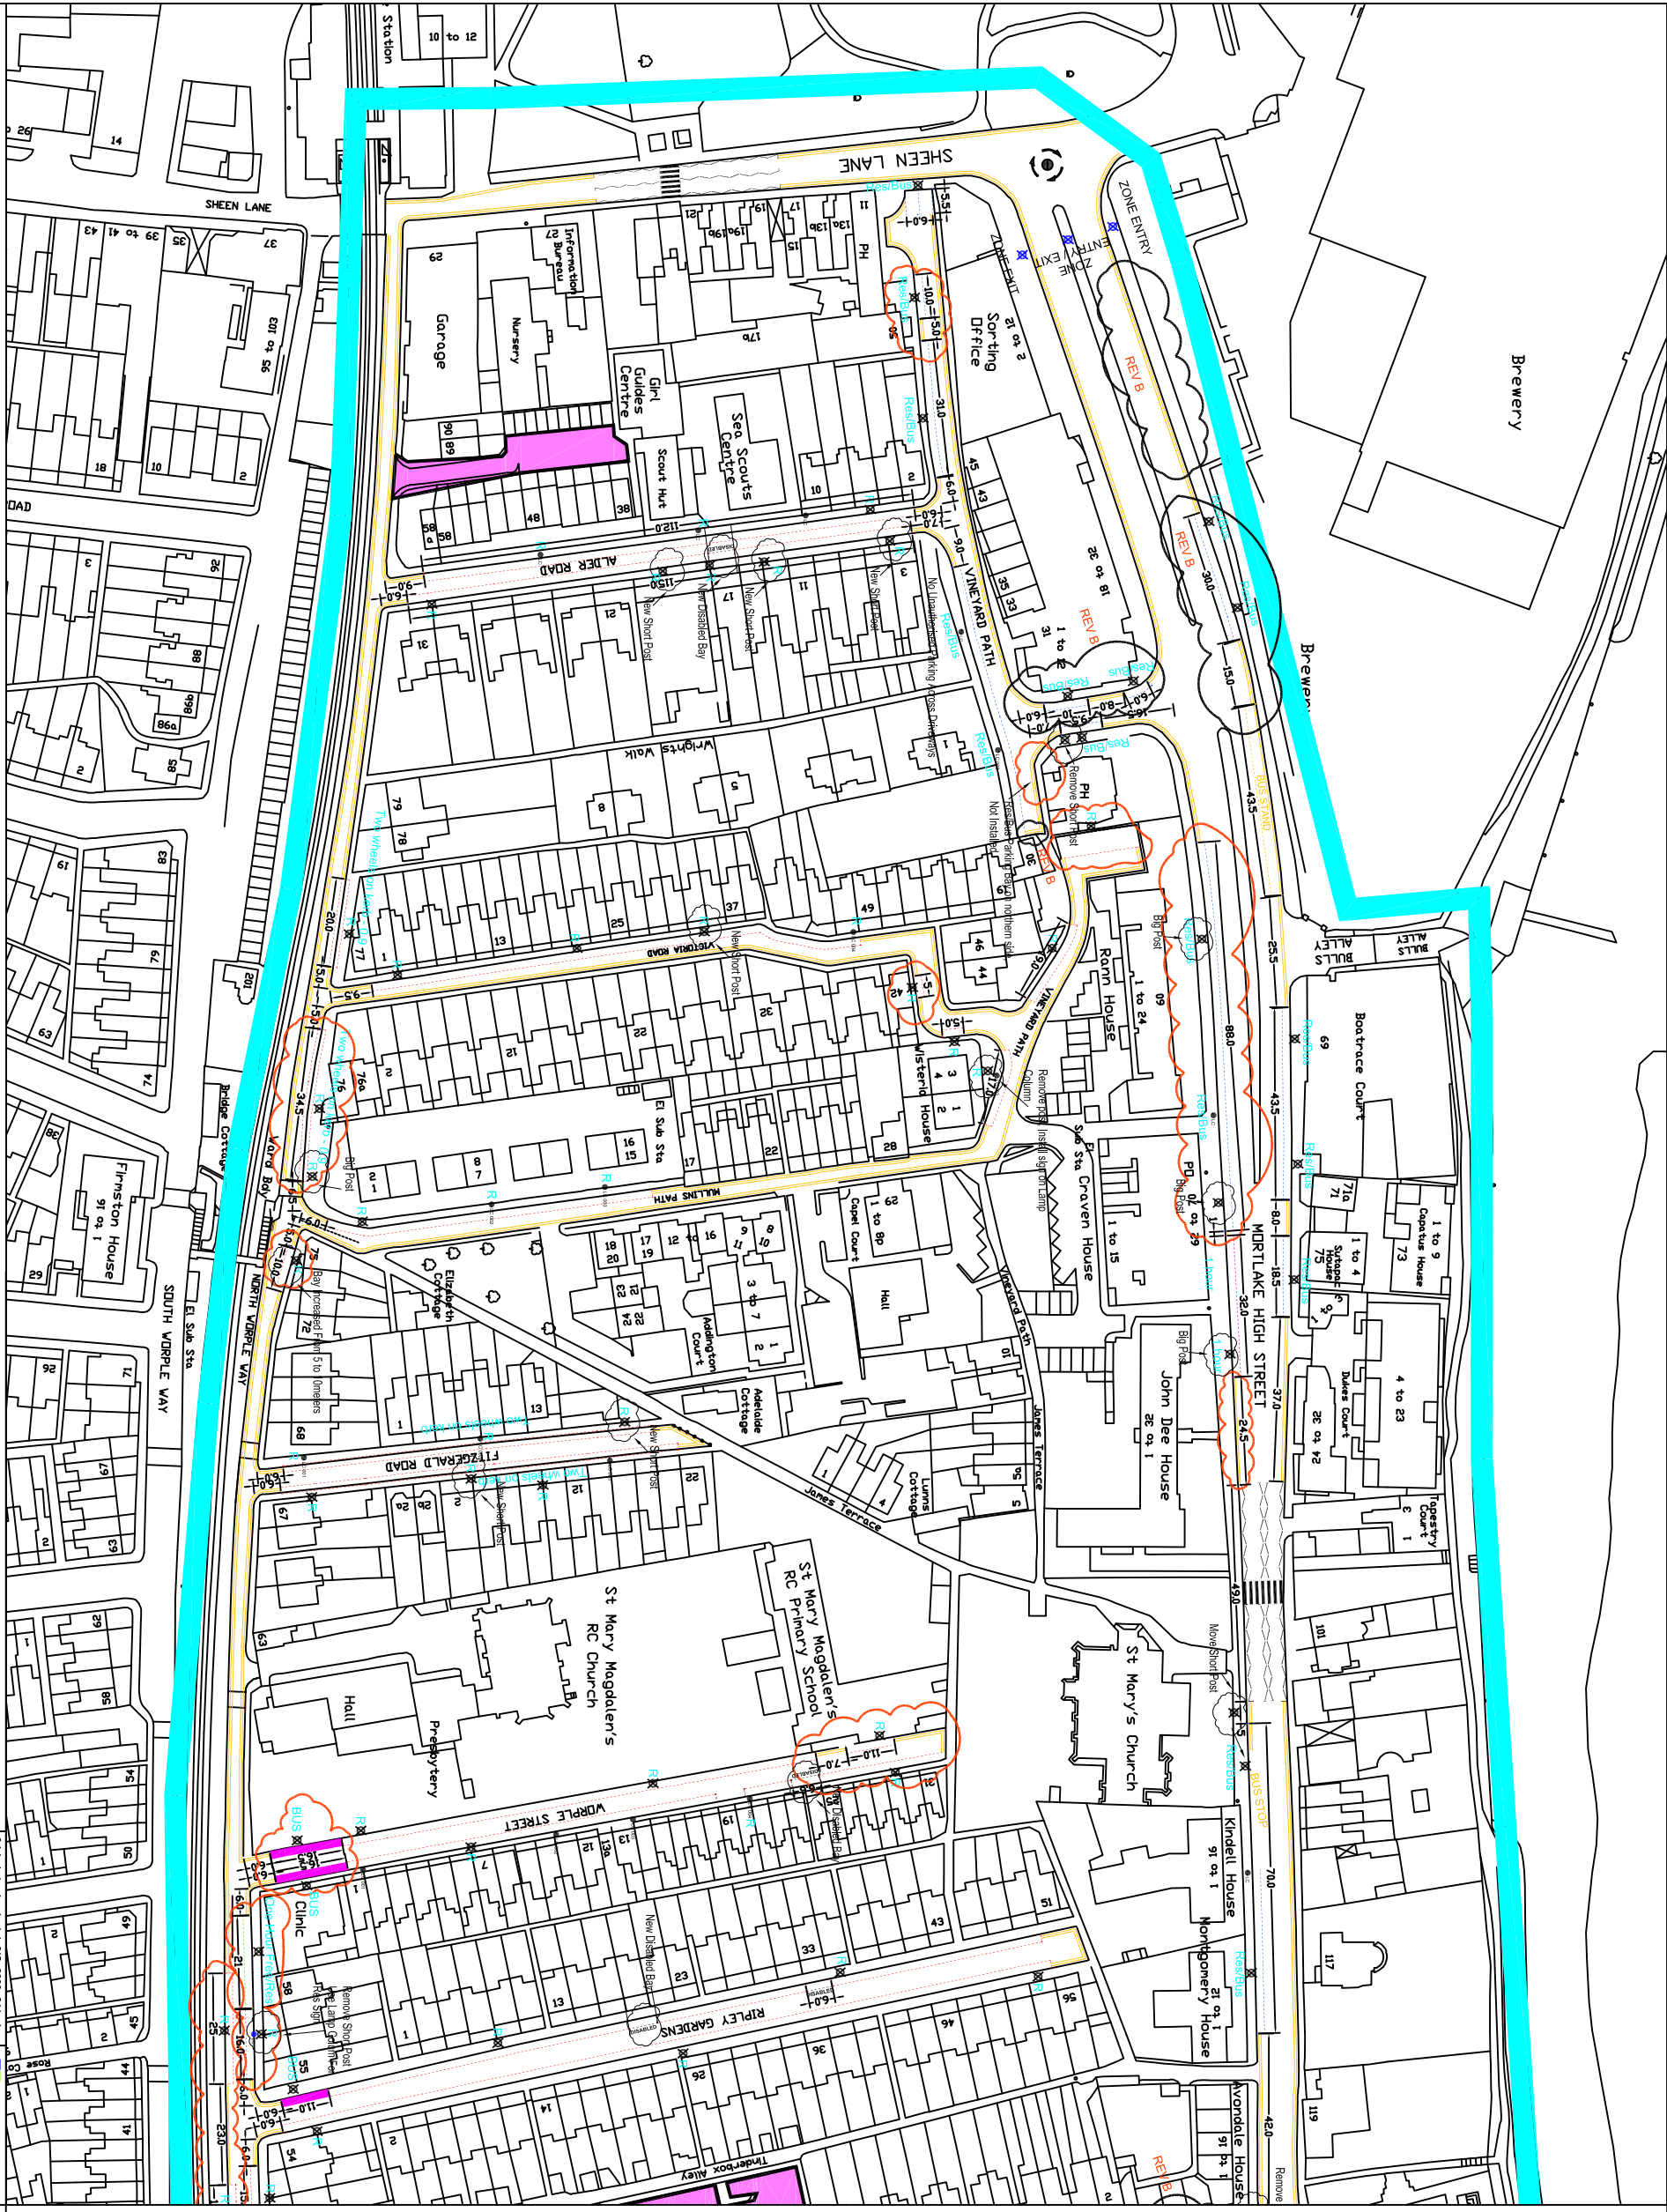

D	PAUL AS BUILT DRAWINGS	Original Date: 01.06.2009
C	MAJOR AMENDMENTS TO COLoured AREAS AS PER SITE MEETING WITH CLD THROU AND 6 RESIDENTS 20TH FEBRUARY 2009	Original Date: 24.02.2009
B	MAJOR AMENDMENTS TO COLOred AREAS	Original Date: 24.02.2009
A	DEFINED DESIGN REGION A	Original Date: 13.01.2009

Original Drawing in AutoCAD 2000 6M1 size.
Reproduced from the Ordnance Survey
Copyright 1994, 1995, 1996, 3821,