


KEY:

- CPZ ES BOUNDARY EXTENSION
- PERMIT PARKING AREA
- BAY TYPES
 - PERMIT PARKING
 - PERMIT PARKING (FOOTWAY)
 - RESIDENTS PARKING
 - PERMIT & P&D (Max stay 1 hour no return within 30 mins)
 - PAY AND DISPLAY
 - RESIDENT AND BUSINESS
 - DISABLED BAY
 - CAR CLUB BAY

- GENERAL
 - DOUBLE YELLOW LINES (50mm)
 - SINGLE YELLOW LINE(50mm)
 - DROPPED KERB
 - ILLEGAL DROPPED KERB
 - FH = FIRE HYDRANT
 - RED ROUTE WAITING RESTRICTIONS
 - RED ROUTE BAY
 - RESTRICTED PARKING ZONE "AT ANY TIME"

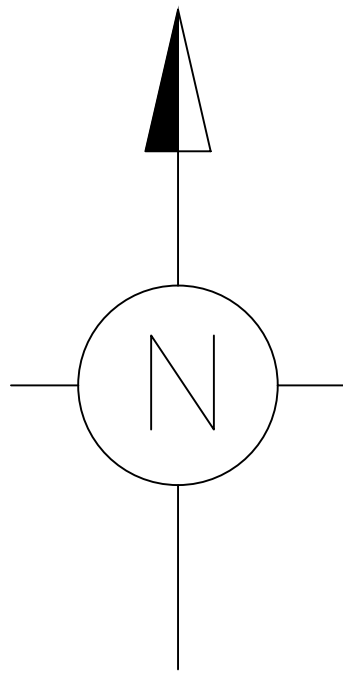

"This map is reproduced from Ordnance Survey material with the permission of the Controller of Her Majesty's Stationery Office ©Crown copyright. Unauthorised reproduction infringes Crown copyright and may lead to prosecution or civil proceedings 100019441 [2019]."

REVISION	AMENDMENT	C.R-W Dec 2019 DRAWN BY AND DATE	C.R-W Dec 2019 DESIGNED BY AND DATE	M.P Dec 2019 CHECKED BY AND DATE	M.T Dec 2019 APPROVED BY AND DATE
		LONDON BOROUGH OF RICHMOND UPON THAMES		DRAFT ISSUE	N.T.S
CLIENT		LONDON BOROUGH OF RICHMOND UPON THAMES			
PROJECT		PARKING PROGRAMME 2019			
DRAWING TITLE		CPZ ES (AS BUILT) Mon – Fri (10am – Noon)			
ISSUING OFFICE		TWICKENHAM	DRAWING NUMBER		REVISION
TELEPHONE		020 88911411	CPZ-ES-AB-1		